



131P2914 AMENDED PLAN


RECEIVED 27/6/14

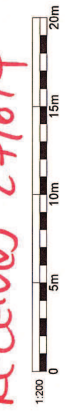

Scale: 1:250

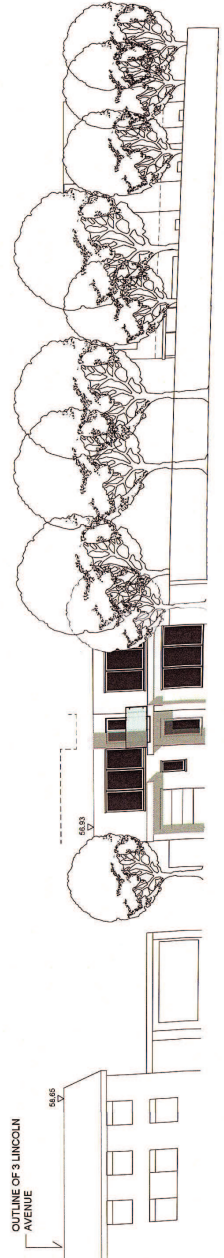

OUTLINE OF 3 LINCOLN AVENUE

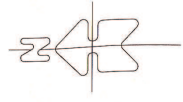

Rev	Date	Description
B	27.06.14	Sheet scheme amended
A	16.04.14	Sheet scheme amended to sh



BANNER HOMES LIMITED
 Riverside House, Halespur Lane, Wood
 High Wycombe, Buckinghamshire, HP12
 3RZ
 Tel: 0494 474747 Fax: 01628 5362
 DX: 123810 Woburn Gwent E-mail: info@bann

Project
 Somerset Road
 Wimbleton

Drawing title
 Site Layout & Street Scene


Scale	1:200 & 250 @ A2
Date	23.07.13
Dwg No.	040177/P
Rev	B



Site layout + Street Scene - Area



RECEIVED 7/7/14

131P2414
ADDITIONAL PLAN
FOR INFO




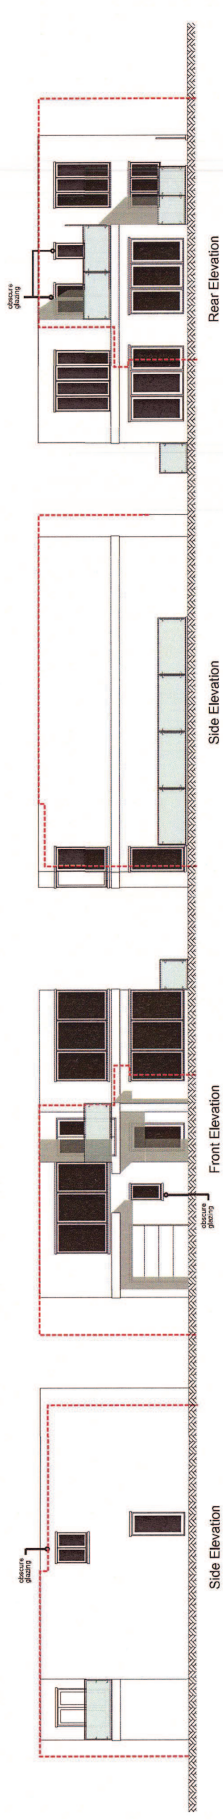


Rev	Date	Description
D	17.07.14	Approved approve outline shown
C	10.06.14	scale bar added
B	27.05.14	Roofing height indicated
A	18.04.14	Approved outline shown in wall

BANNER HOMES LIMITED High Wycombe, Bucks HP12 3JN 0494 000000 DX 12810 Wotton Green, E-mail: info@bannerhomes.co.uk	
Project	Somerset Road Wimbleton
Drawing title	Floor Plans
Scale	1:100 @ A1
Date	16.07.13
Rev	D
Dwg No.	040177/PL_302
Drawn	CLB

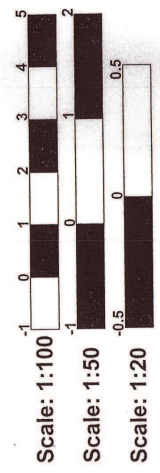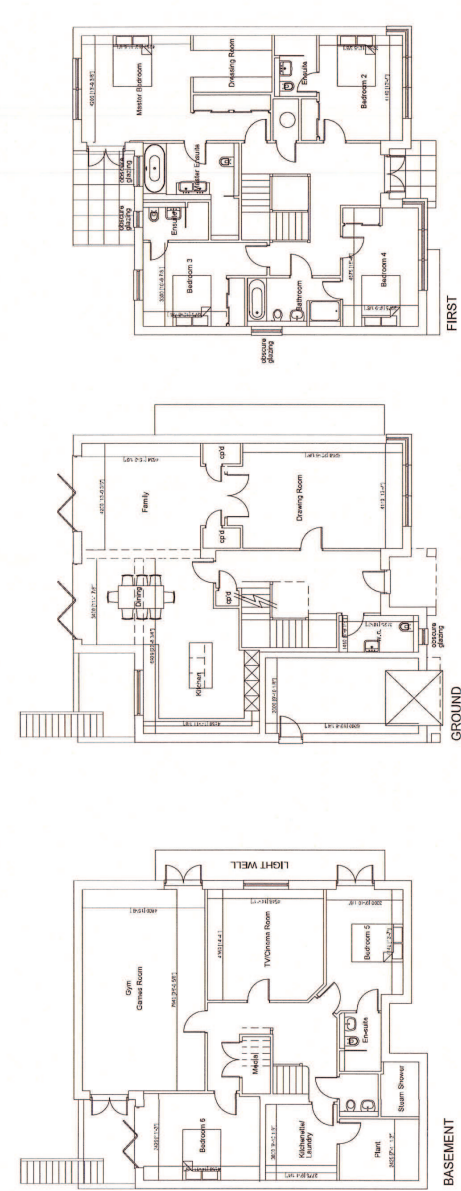

131P 2414 AMENOSO PLAN
 RECEIVED 27/6/14

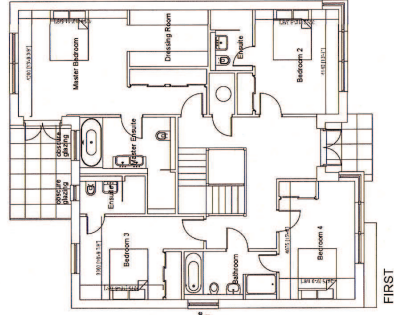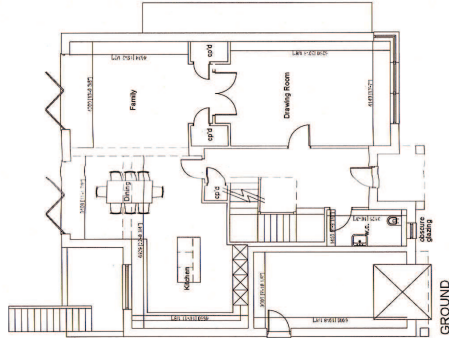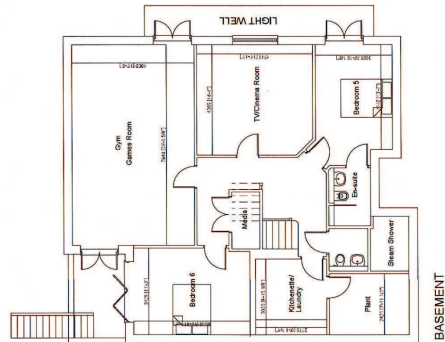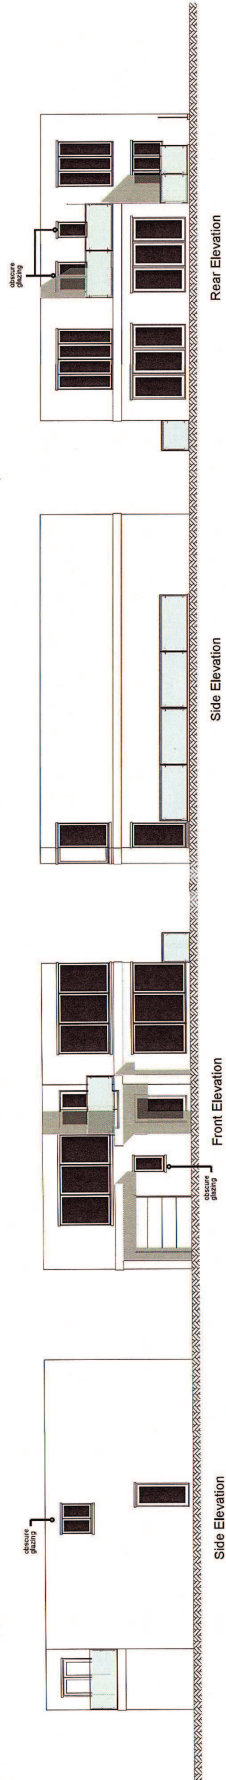


Rev	Date	Description
B	17.06.14	Building height reduced
A	18.03.14	Approved building shown in red



BANNER HOMES LIMITED
 Riverside, Broomfield, Essex, SSO 1 1JY
 High Wycombe, Bucks HP10 0TJ
 01494 470000
 DX: 123519 Woburn Green E-mail: info@banner-homes.co.uk

Project	Somerset Road Wimbleton
Drawing title	Floor Plans
Scale	Dwg No.
1:100 @ A1	040177PL302
Date	Rev
16.07.13	B
Drawn	CLB

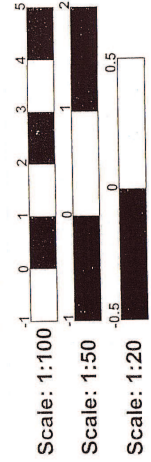

Plans + Elevations Approved