

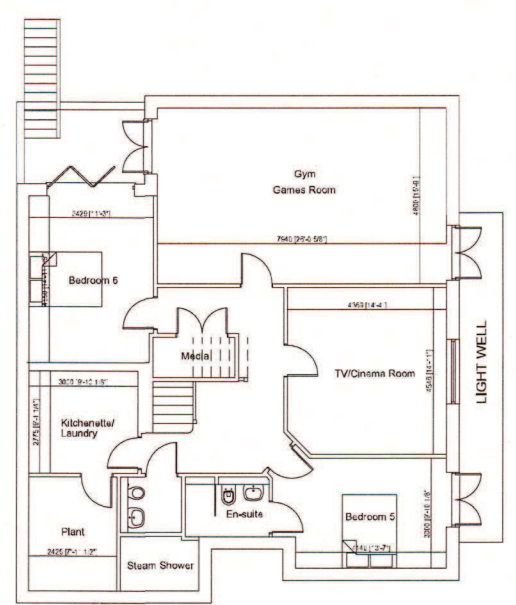


RECEIVED 7/7/14


13/P2914  
ADDITIONAL PLAN  
FOR INFO

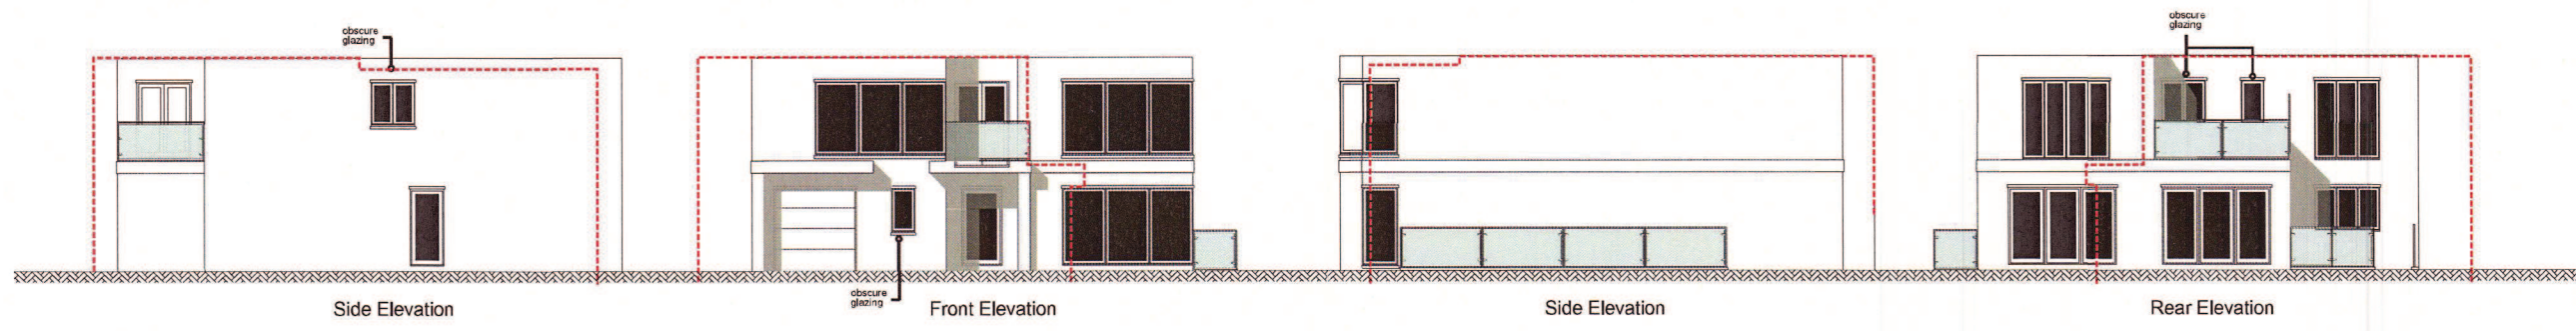

BASEMENT

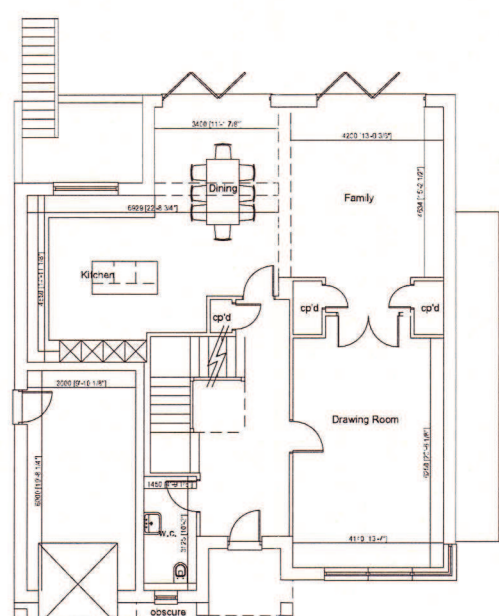

GROUND

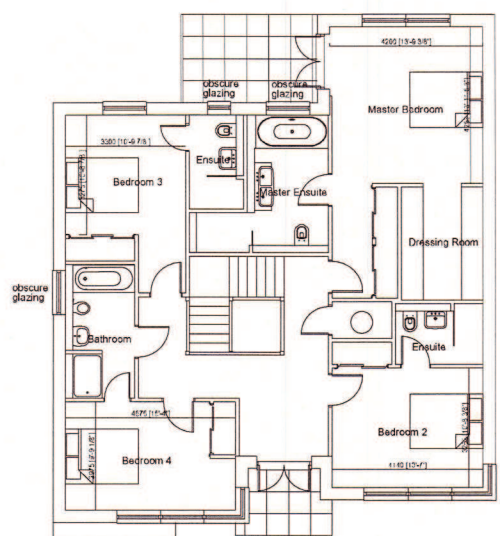

FIRST



Rev	Date	Description
D	07.07.14	amended approve outline shown
C	30.06.14	scale bar added
B	27.05.14	Building height reduced
A	16.04.14	Approved outline shown in red

**BANNER HOMES LIMITED**  
Riverside House, Holtspur Lane, Woburn Green  
High Wycombe, Buckinghamshire, HP10 0TJ  
Tel: 01628 636200 Fax: 01628 636201  
DX: 123610 Woburn Green E-mail: info@banner-homes.co.uk

Project  
Somerset Road  
Wimbledon

Drawing title  
Plot 3  
Floor Plans

Scale 1:100 @ A1	Dwg No. 040177/PL.302
Date 16.07.13	Rev D
Drawn CLB	

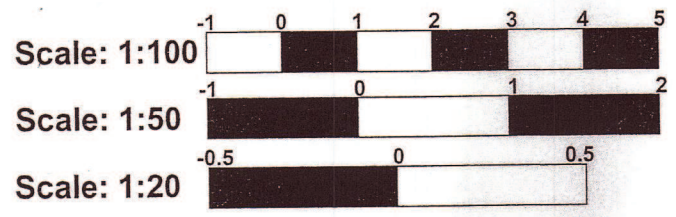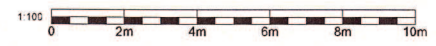

This page is intentionally left blank