

Key Plan 1:2000

Ownership  
Planning



**Waste and Cycle Storage Requirements**

- Please refer to Design & Assess Statement and Transport Technical Note for calculation.
- Red line denotes areas undergoing reconfiguration to meet proposed requirements.

A 01/10/2020 Planning  
Revision Date Description

© copyright Wimshurst Pelleriti, all rights reserved 2019

Do not scale-off this drawing. Wimshurst Pelleriti take no responsibility for any dimensions obtained by measuring or scaling from this drawing and no reliance may be placed on such dimensions. If no dimension is given, it is the responsibility of the recipient to ascertain the dimension specifically from the Architect or by site measurement.

The sizing of all structural and service elements must always be checked against the relevant engineers drawings. No reliance should be placed upon sizing information shown on this drawing.

**Project**  
Bennets Courtyard  
Abbey Mills


**Drawing Title**  
Bennets Courtyard  
Proposed Ground Floor Plan

Drawing Number	Revision
WP-0730-A-BC-0150-P-00	A



Scale @ A0	Revision Date
1:100	04-09-2020

**Drawing Purpose**  
PLANNING

**WIMSHURST PELLERITI**  
The Mews,  
6 Poney Common, SW15 1HL  
0208 780 2208  
info@wp.co.uk  
wimshurst-pelleriti.com

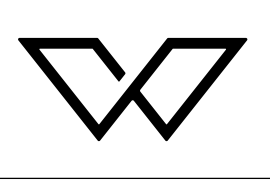



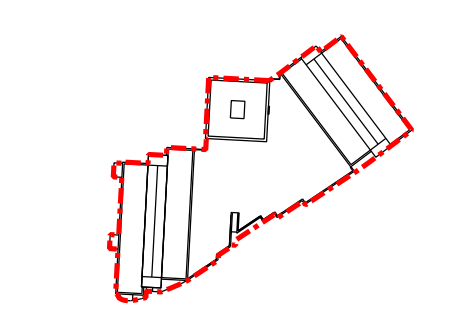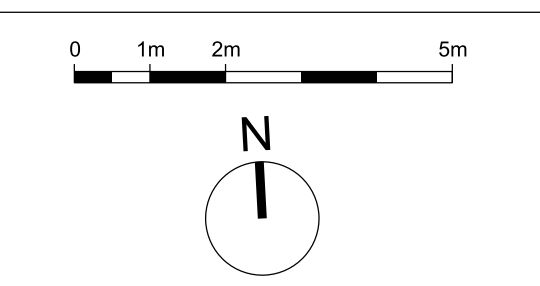

Key Plan 1:2000

--- Ownership  
--- Planning

Red line denotes area where changes are being sought.  
- Stair case extended up to new proposed level 4.  
- Ventilated smoke lobby added on levels 1, 2 and 3 in line with requirements for buildings over 11m.




Revision	Date	Description
A	01/10/2020	Planning

© copyright Wimshurst Pelleriti, all rights reserved 2019  
Do not scale-off this drawing. Wimshurst Pelleriti take no responsibility for any dimensions obtained by measuring or scaling from this drawing and no reliance may be placed on such dimensions. If no dimension is given, it is the responsibility of the recipient to ascertain the dimension specifically from the Architect or by site measurement.



The sizing of all structural and service elements must always be checked against the relevant engineers drawings. No reliance should be placed upon sizing information shown on this drawing.

<b>Project</b> Bennets Courtyard Abbey Mills	
<b>Drawing Title</b> Bennets Courtyard Proposed Third Floor Plan	
<b>Drawing Number</b> WP-0730-A-BC-0153-P-03	<b>Revision</b> A
<b>Scale @ A0</b> 1:100	<b>Revision Date</b> 04-09-2020
<b>Drawing Purpose</b> PLANNING	

**WIMSHURST PELLERITI**  
The Mews,  
6 Putney Common, SW15 1HL  
0208 780 2208  
info@wp.co.uk  
wimshurst-pelleriti.com


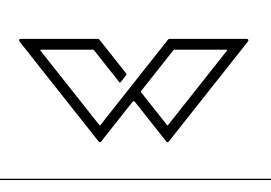




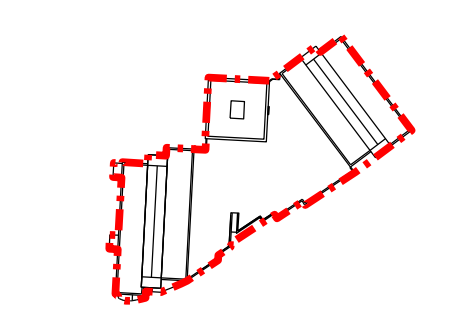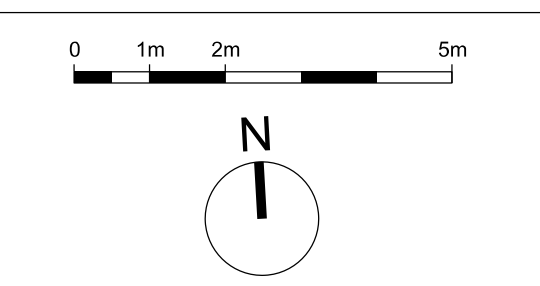

Key Plan 1:2000

— Ownership  
 - - Planning

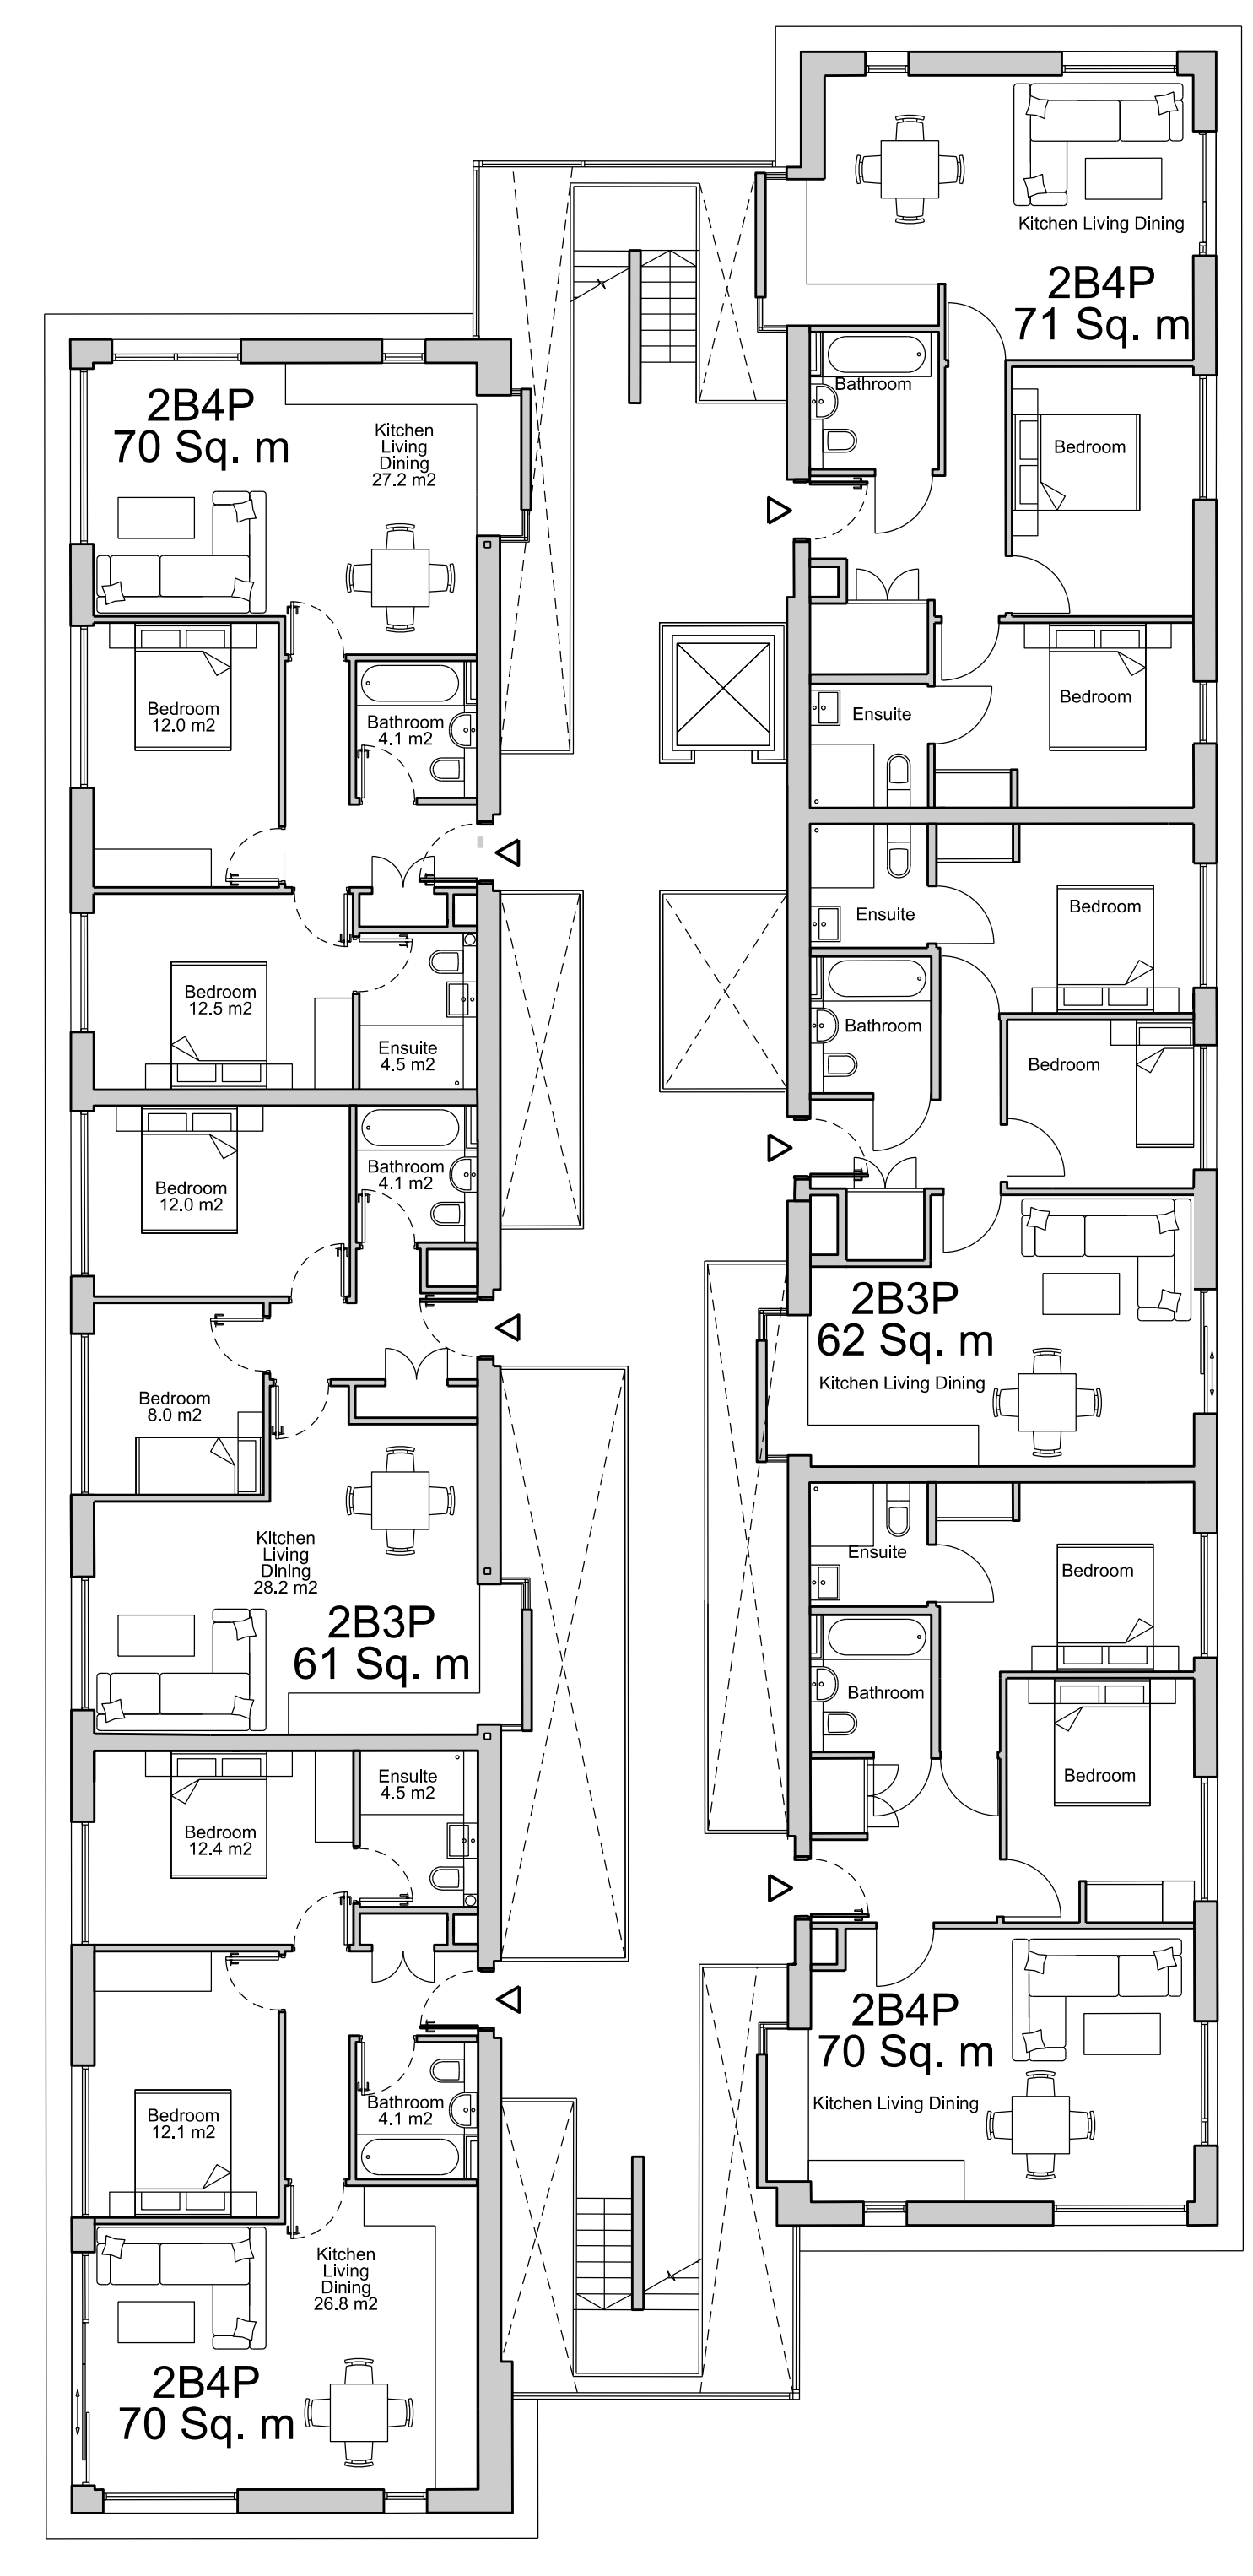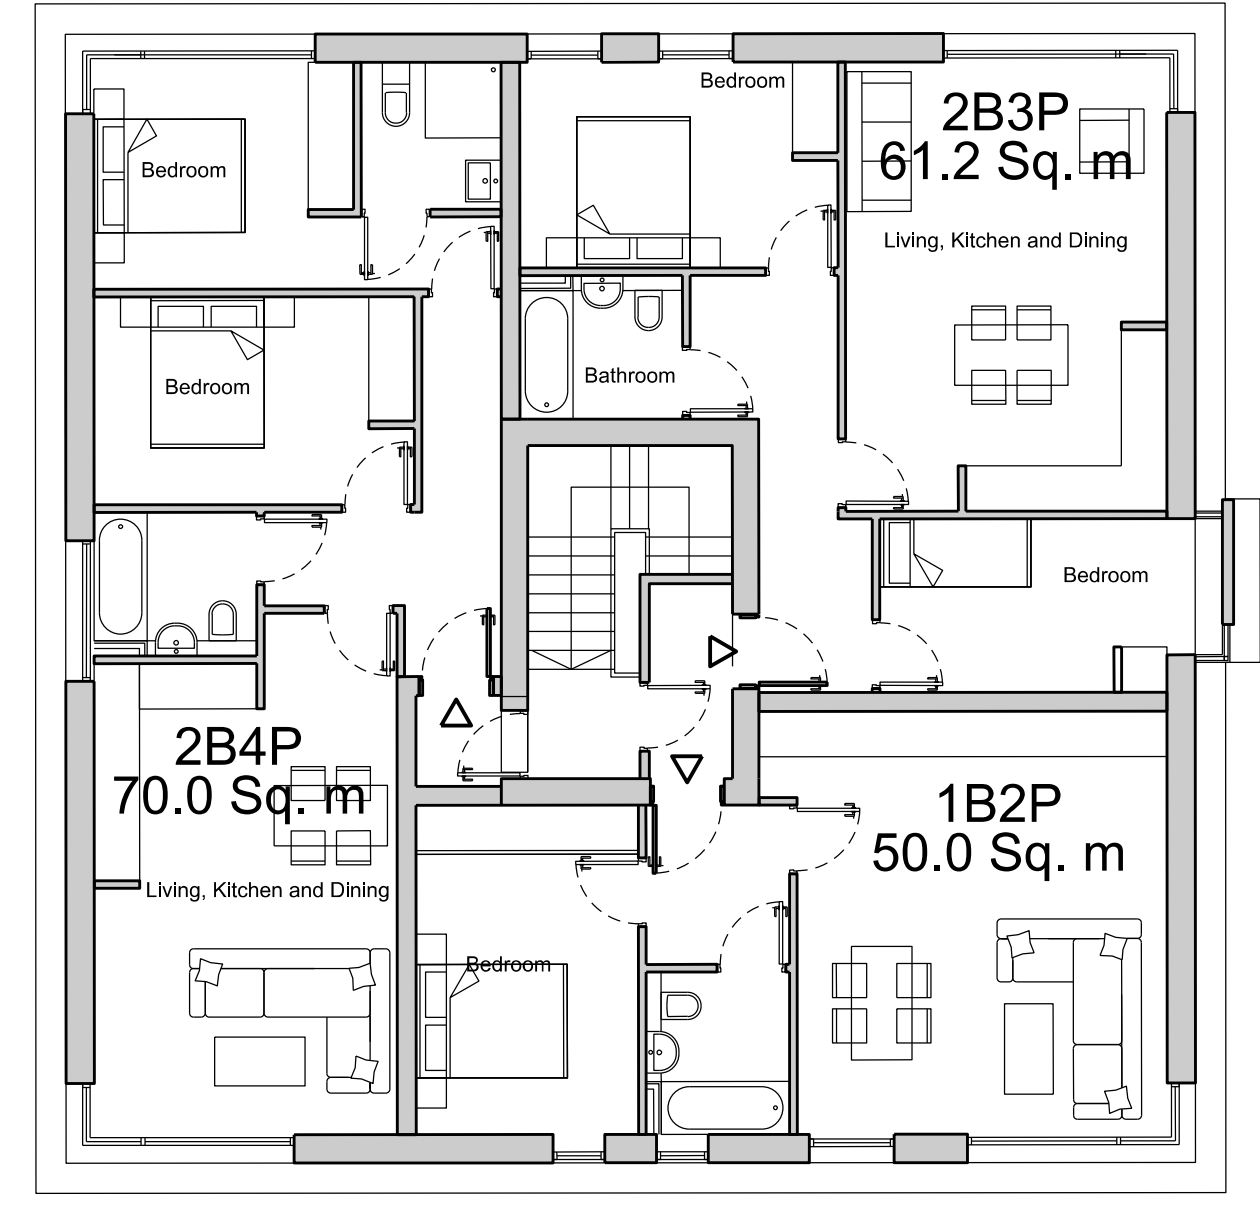

Revision	Date	Description
B	14/05/2021	Planning Revision
A	01/10/2020	Planning


© copyright Wimshurst Pelleriti, all rights reserved 2021

Do not scale-off this drawing. Wimshurst Pelleriti take no responsibility for any dimensions obtained by measuring or scaling from this drawing and no reliance may be placed on such dimensions. If no dimension is given, it is the responsibility of the recipient to ascertain the dimension specifically from the Architect or by site measurement.



The sizing of all structural and service elements must always be checked against the relevant engineers drawings. No reliance should be placed upon sizing information shown on this drawing.

<b>Project</b>	
Bennets Courtyard	
Abbey Mills	
<b>Drawing Title</b>	
Bennets Courtyard Proposed Fourth Floor Plan	
<b>Drawing Number</b>	<b>Revision</b>
WP-0730-A-BC-0154-P-04	B
<b>Scale @ A0</b>	<b>Revision Date</b>
1:100	04-09-2020
<b>Drawing Purpose</b>	
PLANNING	

**WIMSHURST PELLERITI**  
 The Mews,  
 6 Putey Common, SW15 1HL  
 0208 780 2208  
 info@wp-uk.com  
 wimshurst-pelleriti.com






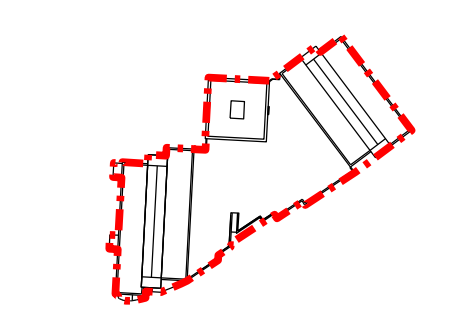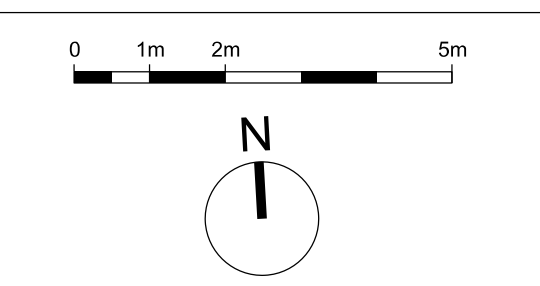

Key Plan 1:2000

--- Ownership  
--- Planning

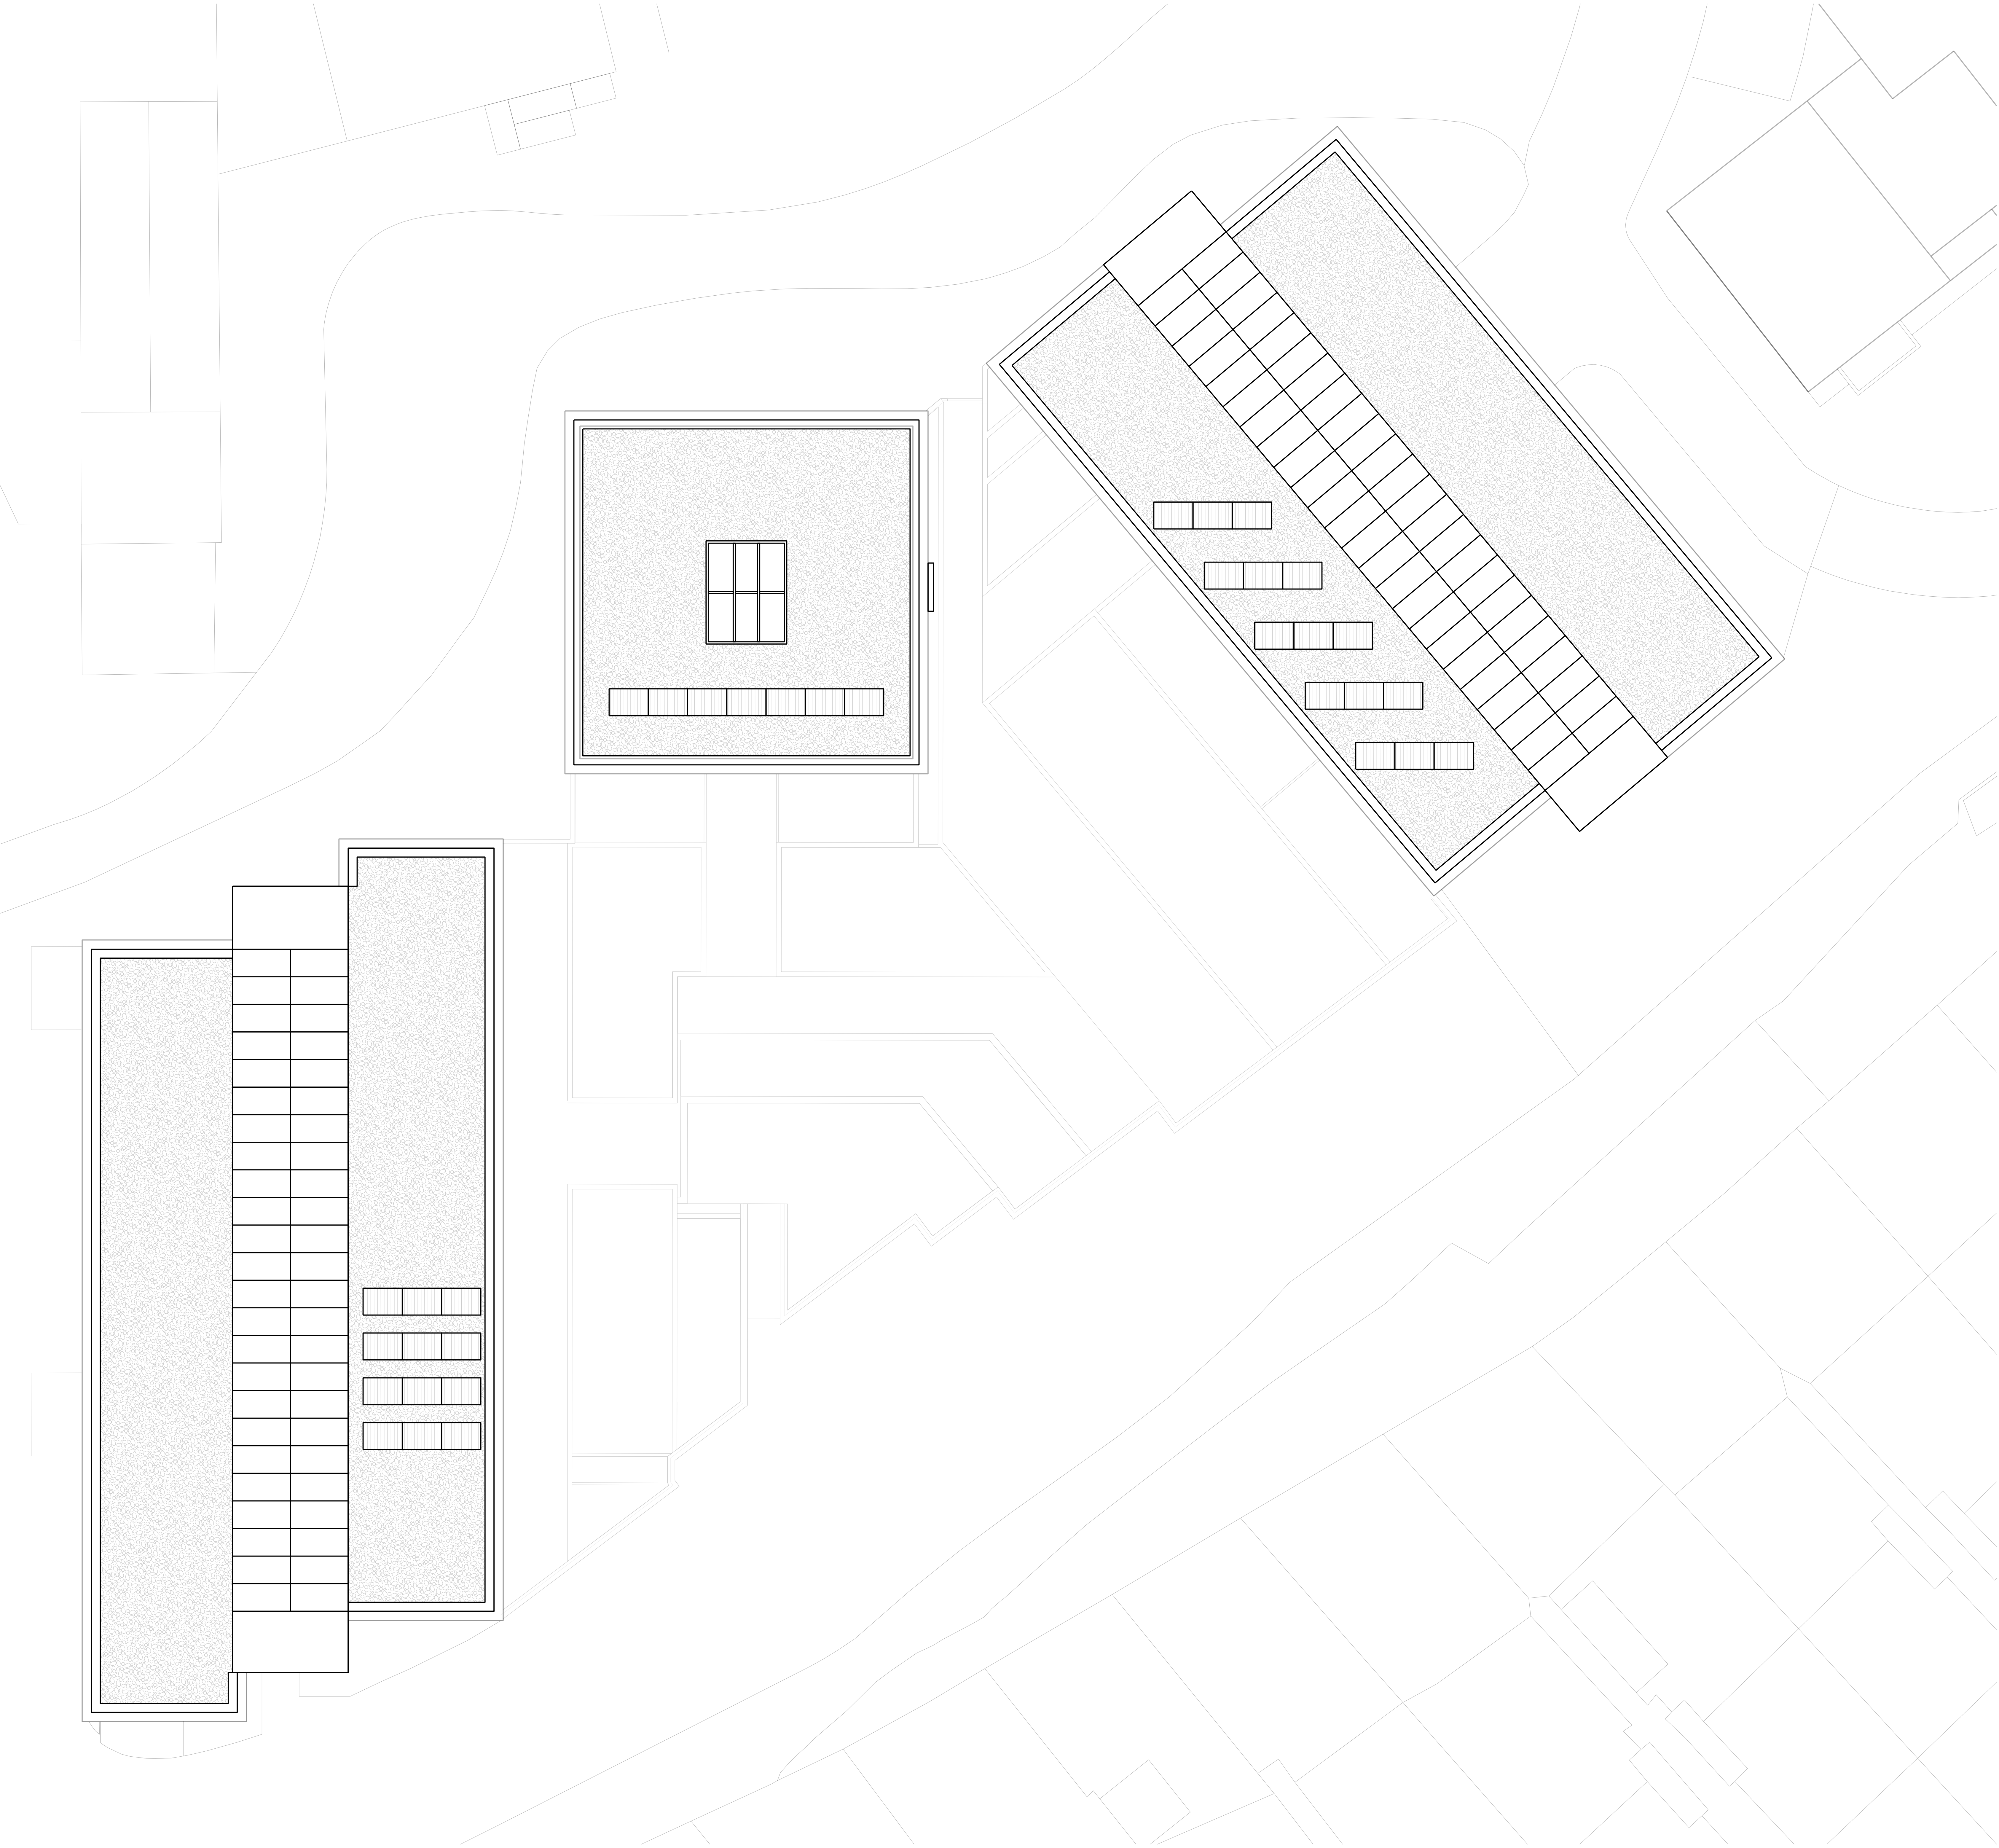

Revision	Date	Description
B	14/05/2021	Planning Revision
A	01/10/2020	Planning

© copyright Wimshurst Pelleriti, all rights reserved 2021

Do not scale-off this drawing. Wimshurst Pelleriti take no responsibility for any dimensions obtained by measuring or scaling from this drawing and no reliance may be placed on such dimensions. If no dimension is given, it is the responsibility of the recipient to ascertain the dimension specifically from the Architect or by site measurement.

The sizing of all structural and service elements must always be checked against the relevant engineers drawings. No reliance should be placed upon sizing information shown on this drawing.

**Project**  
Bennets Courtyard  
Abbey Mills

**Drawing Title**  
Bennets Courtyard  
Proposed Roof Plan


Drawing Number	Revision
WP-0730-A-BC-0155-P-05	B

Scale @ A0  
1:100


Revision Date  
04-09-2020

**Drawing Purpose**  
PLANNING

**WIMSHURST PELLERITI**  
The Mews,  
6 Pimley Common, SW15 1HL  
0208 780 2208  
info@wp-uk.com  
wimshurst-pelleriti.com





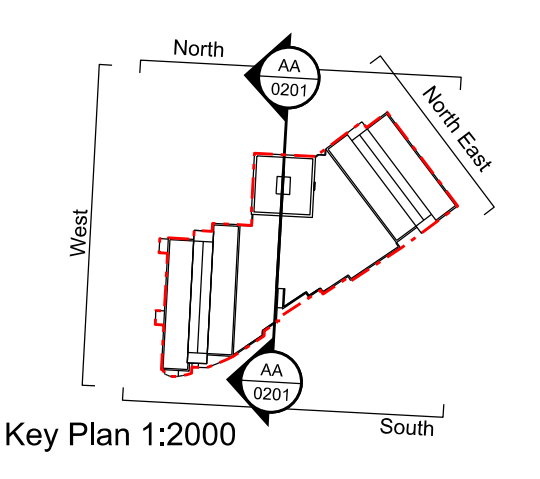

Key Plan 1:2000



01  
0250 Proposed South Elevation  
1:100@A0



03  
0250 Proposed North Elevation  
1:100@A0



04  
0250 Proposed North East Elevation  
1:100@A0

B	14/05/2021	Planning	Revision
A	01/10/2020	Planning	Revision
			Description

© copyright Wimshurst Pelleriti, all rights reserved 2021  
Do not scale-off this drawing. Wimshurst Pelleriti take no responsibility for any dimensions obtained by measuring or scaling from this drawing and no reliance may be placed on such dimensions. If no dimension is given, it is the responsibility of the recipient to ascertain the dimension specifically from the Architect or by site measurement.


The sizing of all structural and service elements must always be checked against the relevant engineers drawings. No reliance should be placed upon sizing information shown on this drawing.

<b>Project</b>	
Bennets Courtyard	
Abbey Mills	
<b>Drawing Title</b>	
Bennets Courtyard Proposed Elevations	
<b>Drawing Number</b>	<b>Revision</b>
WP-0730-A-BC-0250-E-X	B
<b>Scale @ A0</b>	<b>Revision Date</b>
1:100	04-09-2020
<b>Drawing Purpose</b>	
PLANNING	


**WIMSHURST PELLERITI**  
The Mews,  
6 Pimley Common, SW15 1HL  
0208 780 2208  
info@wp-uk.com  
wimshurst-pelleriti.com





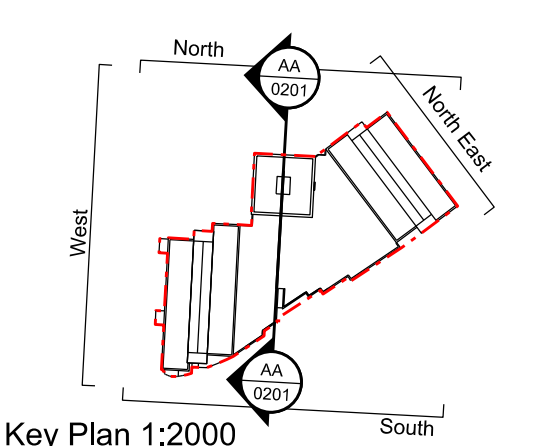

Key Plan 1:2000

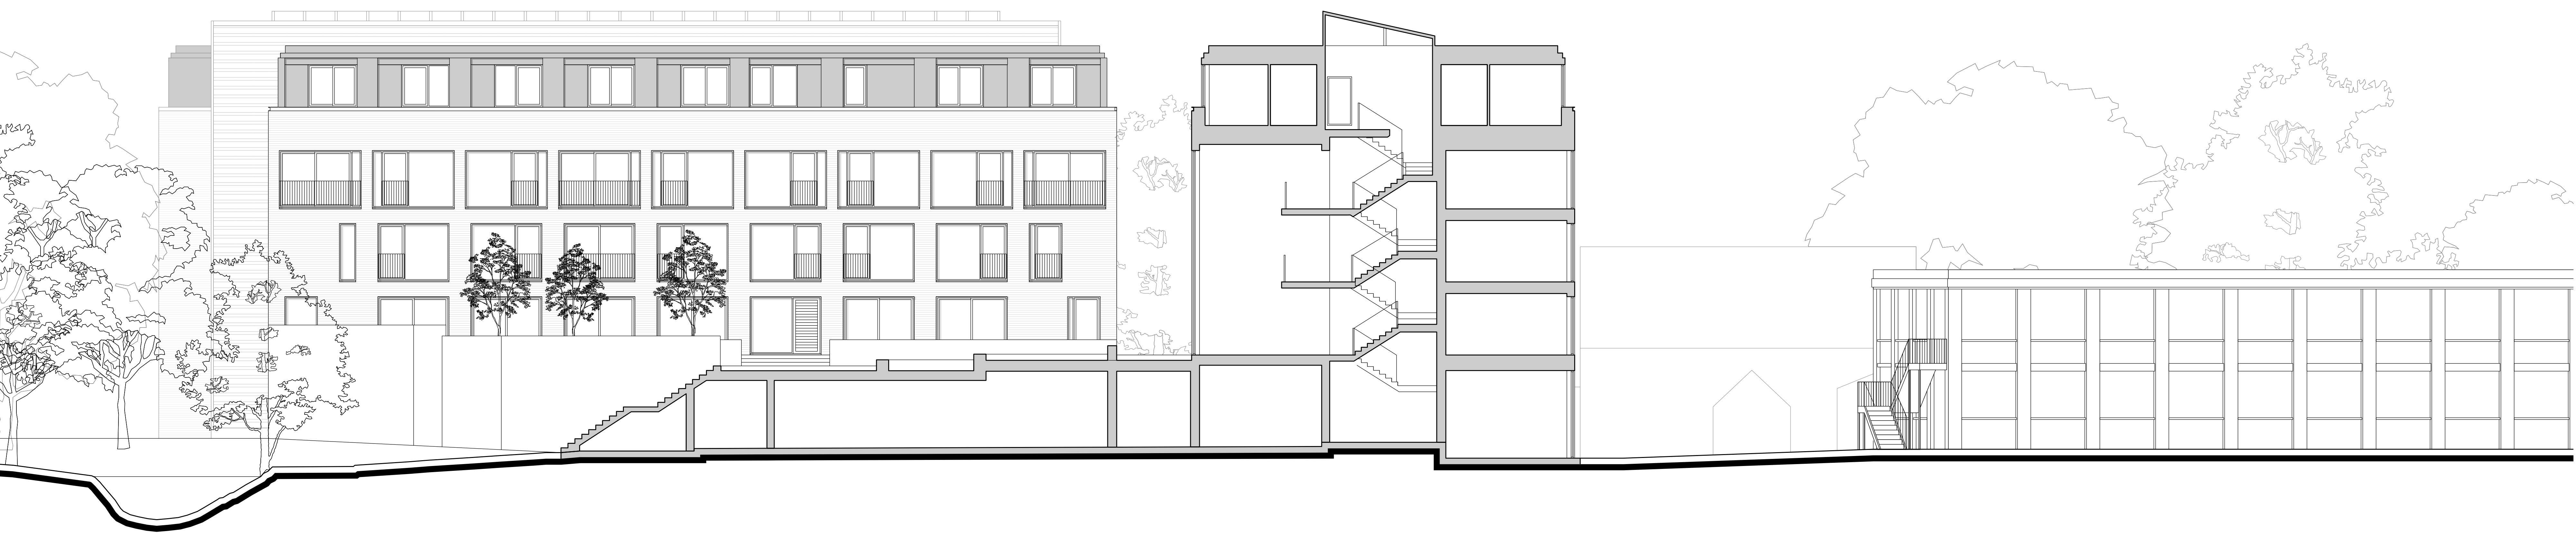

01  
0251 Proposed Section A-A  
1:100@A0

Page 454



02  
0251 Proposed West Elevation  
1:100@A0

B	14/05/2021	Planning	Revision
A	01/10/2020	Planning	Description

© copyright Wimshurst Pelleriti, all rights reserved 2021  
Do not scale-off this drawing. Wimshurst Pelleriti take no responsibility for any dimensions obtained by measuring or scaling from this drawing and no reliance may be placed on such dimensions. If no dimension is given, it is the responsibility of the recipient to ascertain the dimension specifically from the Architect or by site measurement.  
The sizing of all structural and service elements must always be checked against the relevant engineers drawings. No reliance should be placed upon sizing information shown on this drawing.

**Project**  
Bennets Courtyard  
Abbey Mills

**Drawing Title**  
Bennets Courtyard  
Proposed Elevation and Section A-A

Drawing Number	Revision
WP-0730-A-BC-0251-E-X	B

Scale @ A0  
1:100

Revision Date  
04-09-2020

**Drawing Purpose**  
PLANNING

**WIMSHURST PELLERITI**  
The Mews,  
6 Putney Common, SW15 1HL  
0208 780 2208  
info@wp-uk.com  
wimshurst-pelleriti.com




01  
0260 Proposed West Elevation 1:50@A1



02  
0260 Proposed South Elevation 1:50@A1

0 50cm 1m 2m 3m

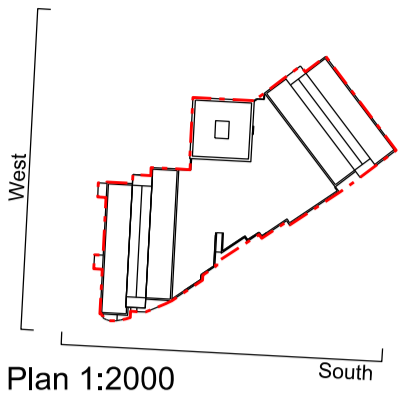

Key Plan 1:2000

Revision	Date	Description
B	14/05/2021	Planning Revision
A	01/10/2020	Planning

© copyright Wimshurst Pelleriti, all rights reserved 2021

Do not scale-off this drawing, Wimshurst Pelleriti take no responsibility for any dimensions obtained by measuring or scaling from this drawing and no reliance may be placed on such dimensions. If no dimension is given, it is the responsibility of the recipient to ascertain the dimension specifically from the Architect or by site measurement.

The sizing of all structural and service elements must always be checked against the relevant engineers drawings. No reliance should be placed upon sizing information shown on this drawing.

**Project**  
Bennets Courtyard  
Abbey Mills

---

**Drawing Title**  
Bennets Courtyard  
Proposed Detail Bay Elevation

---

Drawing Number	Revision
WP-0730-A-BC-0260-E-X	B

---

Scale @ A1	Revision Date
1:50	04-09-2020


---

**Drawing Purpose**  
PLANNING

---

**WIMSHURST PELLERITI**

The Mews,  
6 Putney Common, SW15 1HL  
0208 780 2206  
Info@wp.uk.com  
wimshurst-pelleriti.com



This page is intentionally left blank